



TOWN OF CLAREMONT
RECEIVED
9/07/2026

ESD Section J Preliminary Advice

This document has been prepared for Total Project Management for the St. Louis Estate project as a preliminary advice to assess the proposed Class 3 building’s compliance with **NCC 2025 Volume One, Section J**.

Thermal Performance Requirements

The minimum thermal performance requirements for building fabric elements forming the building envelope are summarised in the tables below. These requirements are indicative only and subject to confirmation following detailed coordination with the Architect and completion of Section J modelling by Summation.

Table 1: Building Fabric Thermal Performance Requirements

Location	Description	Minimum Total System R-value [m².K/W]	Minimum Typical Insulation [m².K/W]	Example Typical Insulation
Roofs ¹	Metal Deck with Ceiling	R3.7	R3.65	80mm R3.65 refl. rigid board
	Concrete Suspended Slab		R1.8 + R2.5	80mm R1.8 refl. glasswool blanket + 140mm R2.5 glasswool ceiling batts
External Walls ²	Opt. 1: Brick Cavity Wall	R1.4	R0.83	30mm R0.83 rigid rockwool batts
	Opt. 2: Reverse Brick Veneer		R2.5	90mm R2.5 glasswool batts + unventilated cavity or R0.2 thermal break
Internal Walls	Concrete w. Internal Lining	R1.0	R0.7	25mm R0.7 over wall clips
Floor	Exposed Suspended Slab	R2.0	R1.75	40mm R1.75 soffit board (suspended slab only)

¹ Solar absorptance of the upper surface of the roofs must be less or equal to 0.35 (where air intakes, or rooftop plant is installed).

² Solar absorptance of the outer surface of the external walls must be less or equal to 0.60.



TOWN OF CLAREMONT
RECEIVED
9/07/2026

Table 2: Glazing Thermal Performance Requirements

Type	Total System U-value [W/m ² .K]	Solar Heat Gain Coefficient (SHGC)	Example Typical Glazing
Glazing ³ • 58% WWR to North • 26% WWR to East • 29% WWR to South • 40% WWR to West	2.9	0.27	High performance low-E double glazing in aluminium frame.

Note: the above glazing performance values apply to all vision glazing and are stated as whole-of-system requirements, inclusive of framing and glass, and in accordance with Australian Fenestration Rating Council (AFRC) requirement.

It is noted the above whole-of-system window performance requirements are the area-weighted average performance of all vision glazing elements within the building. It is recognised some glazing elements will be above and some will be below the stated figures.

The Window Supplier / Contractor must provide aggregated area-weighted glazing performance data and calculations to Summation for review to verify compliance with the above requirements.

³ Window-to-wall ratio (WWR) calculation is based on the comparison between vision glazing to opaque façade areas. All non-vision areas are to be treated as external wall construction



Appendix A Example R-Value Calculations

Roof/Ceiling – Metal Deck with Ceiling				
Item	Component	Thickness (mm)	Framing Material & Percentage	Effective R-value [m ² .K/W]
1	Outdoor Air Film	N/A		0.03
2	Steel	0.5		0.00
3	R1.8 Reflective (E≤0.05) Glasswool Blanket (with 60 mm spacer / non-compressed)	80		1.80
4	Airspace (reflective, unventilated)	≥ 300		1.09
5	R2.5 Glasswool Ceiling Batts	140	Steel – 8%	1.85
6	Gypsum Plasterboard	13		0.08
7	Indoor Air Film (Still Air)	N/A		0.16
Calculated Total System R-value				5.01

Roof/Ceiling – Concrete Suspended Slab				
Item	Component	Thickness (mm)	Framing Material & Percentage	Effective R-value [m ² .K/W]
1	Outdoor Air Film	N/A		0.03
2	Solid Concrete	≥ 300		0.21
3	R3.65 Reflective (E≤0.05) Rigid Board	80		3.65
4	Indoor Air Film (Still Air)	N/A		0.16
Calculated Total System R-value				4.05



External Wall – Option 1: Brick Cavity Wall

Item	Component	Thickness [mm]	Framing [%]	Effective R-value [m ² .K/W]
1	Outdoor Air Film	N/A		0.03
2	Clay Brick	110		0.14
3	Airspace (non-reflective, unventilated)	≥20		0.16
4	R0.83 Rigid Rockwool Batts	30		0.83
5	Clay Brick	110		0.14
6	Indoor Air Film (Still Air)	N/A		0.12
Calculated Total System R-value				1.42

External Wall – Option 2: Reverse Brick Veneer

Item	Component	Thickness [mm]	Framing [%]	Effective R-value [m ² .K/W]
1	Outdoor Air Film	N/A		0.03
2	Fibre Cement	6		0.00
3	Airspace (non-reflective, ventilated)	≥20		0.00
4	R2.5 Glasswool Batts	90	Steel – 13%	0.95
5	Airspace (non-reflective, unventilated)	≥20		0.16
6	Clay Brick	110		0.14
7	Indoor Air Film (Still Air)	N/A		0.12
Calculated Total System R-value				1.40



Internal Wall – Concrete w. Internal Lining (i.e., columns, shafts, risers)

Item	Component	Thickness (mm)	Framing Material & Percentage	Effective R-value [m ² .K/W]
1	Outdoor Air Film	N/A		0.03
2	Solid Concrete	≥350		0.24
3	R0.7 Glasswool Batts (continous over furring channel clips)	25	Steel – 2.5%	0.43
4	Airspace (non-reflective, unventilated)	≥20	Steel - 17%	0.13
5	Plasterboard Gypsum	13		0.08
6	Indoor Air Film (Still Air)	N/A		0.12
Calculated Total System R-value				1.03

Floor – Suspended Slab

Item	Component	Thickness (mm)	Framing Material & Percentage	Effective R-value [m ² .K/W]
1	Indoor Air Film (Still Air)	N/A		0.16
2	Solid Concrete	250		0.17
3	R1.75 Phenolic Rigid Board Insulation	40		1.75
4	Outdoor Air Film	N/A		0.03
Calculated Total System R-value				2.06




St. Louis Estate | ESD Section J Preliminary Advise
Project Ref: SUPER26018
Date: 07/07/26



Appendix B Insulation Markups

Disclaimer

1. Do not scale drawings. Written dimensions govern.
2. All Dimensions are in millimeters unless otherwise noted.
3. All Dimensions are to be verified on site prior to proceeding with the work.
4. Kerry Hill Architects are to be notified in writing of any discrepancies.
5. This drawing must be read in conjunction with all relevant contracts, reports specification and drawings.
6. This document has been prepared by Kerry Hill Architects Pty Ltd (KHA) for the purpose of conveying design intent. This document does not represent a complete design and is for the purpose of ongoing coordination between the relevant specialist consultants. KHA has made every effort to maintain the accuracy of the documents. It does not accept liability for loss or damage incurred as a result of the use, or reliance on the accuracy, of this information. All recipients of this document should make their own enquiries to verify the content themselves and with all other relevant disciplines. This document does not form part of any construction contract and should not be relied upon for the purpose of construction.

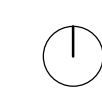

LEGEND

Unconditioned

Min. Total System Performance

Roof - Total R3.7 & SA $\leq$ 0.35


Walls¹ - Total R1.4 & SA $\leq$ 0.60

Walls¹ - Total R1.0


Floor - Total R2.0 (Soffit Insulation)

¹All envelope walls to be floor to soffit.

Project: St Louis Estate
Project Ref: SUPER26018
Prepared by: JB
Date: 07/07/2026

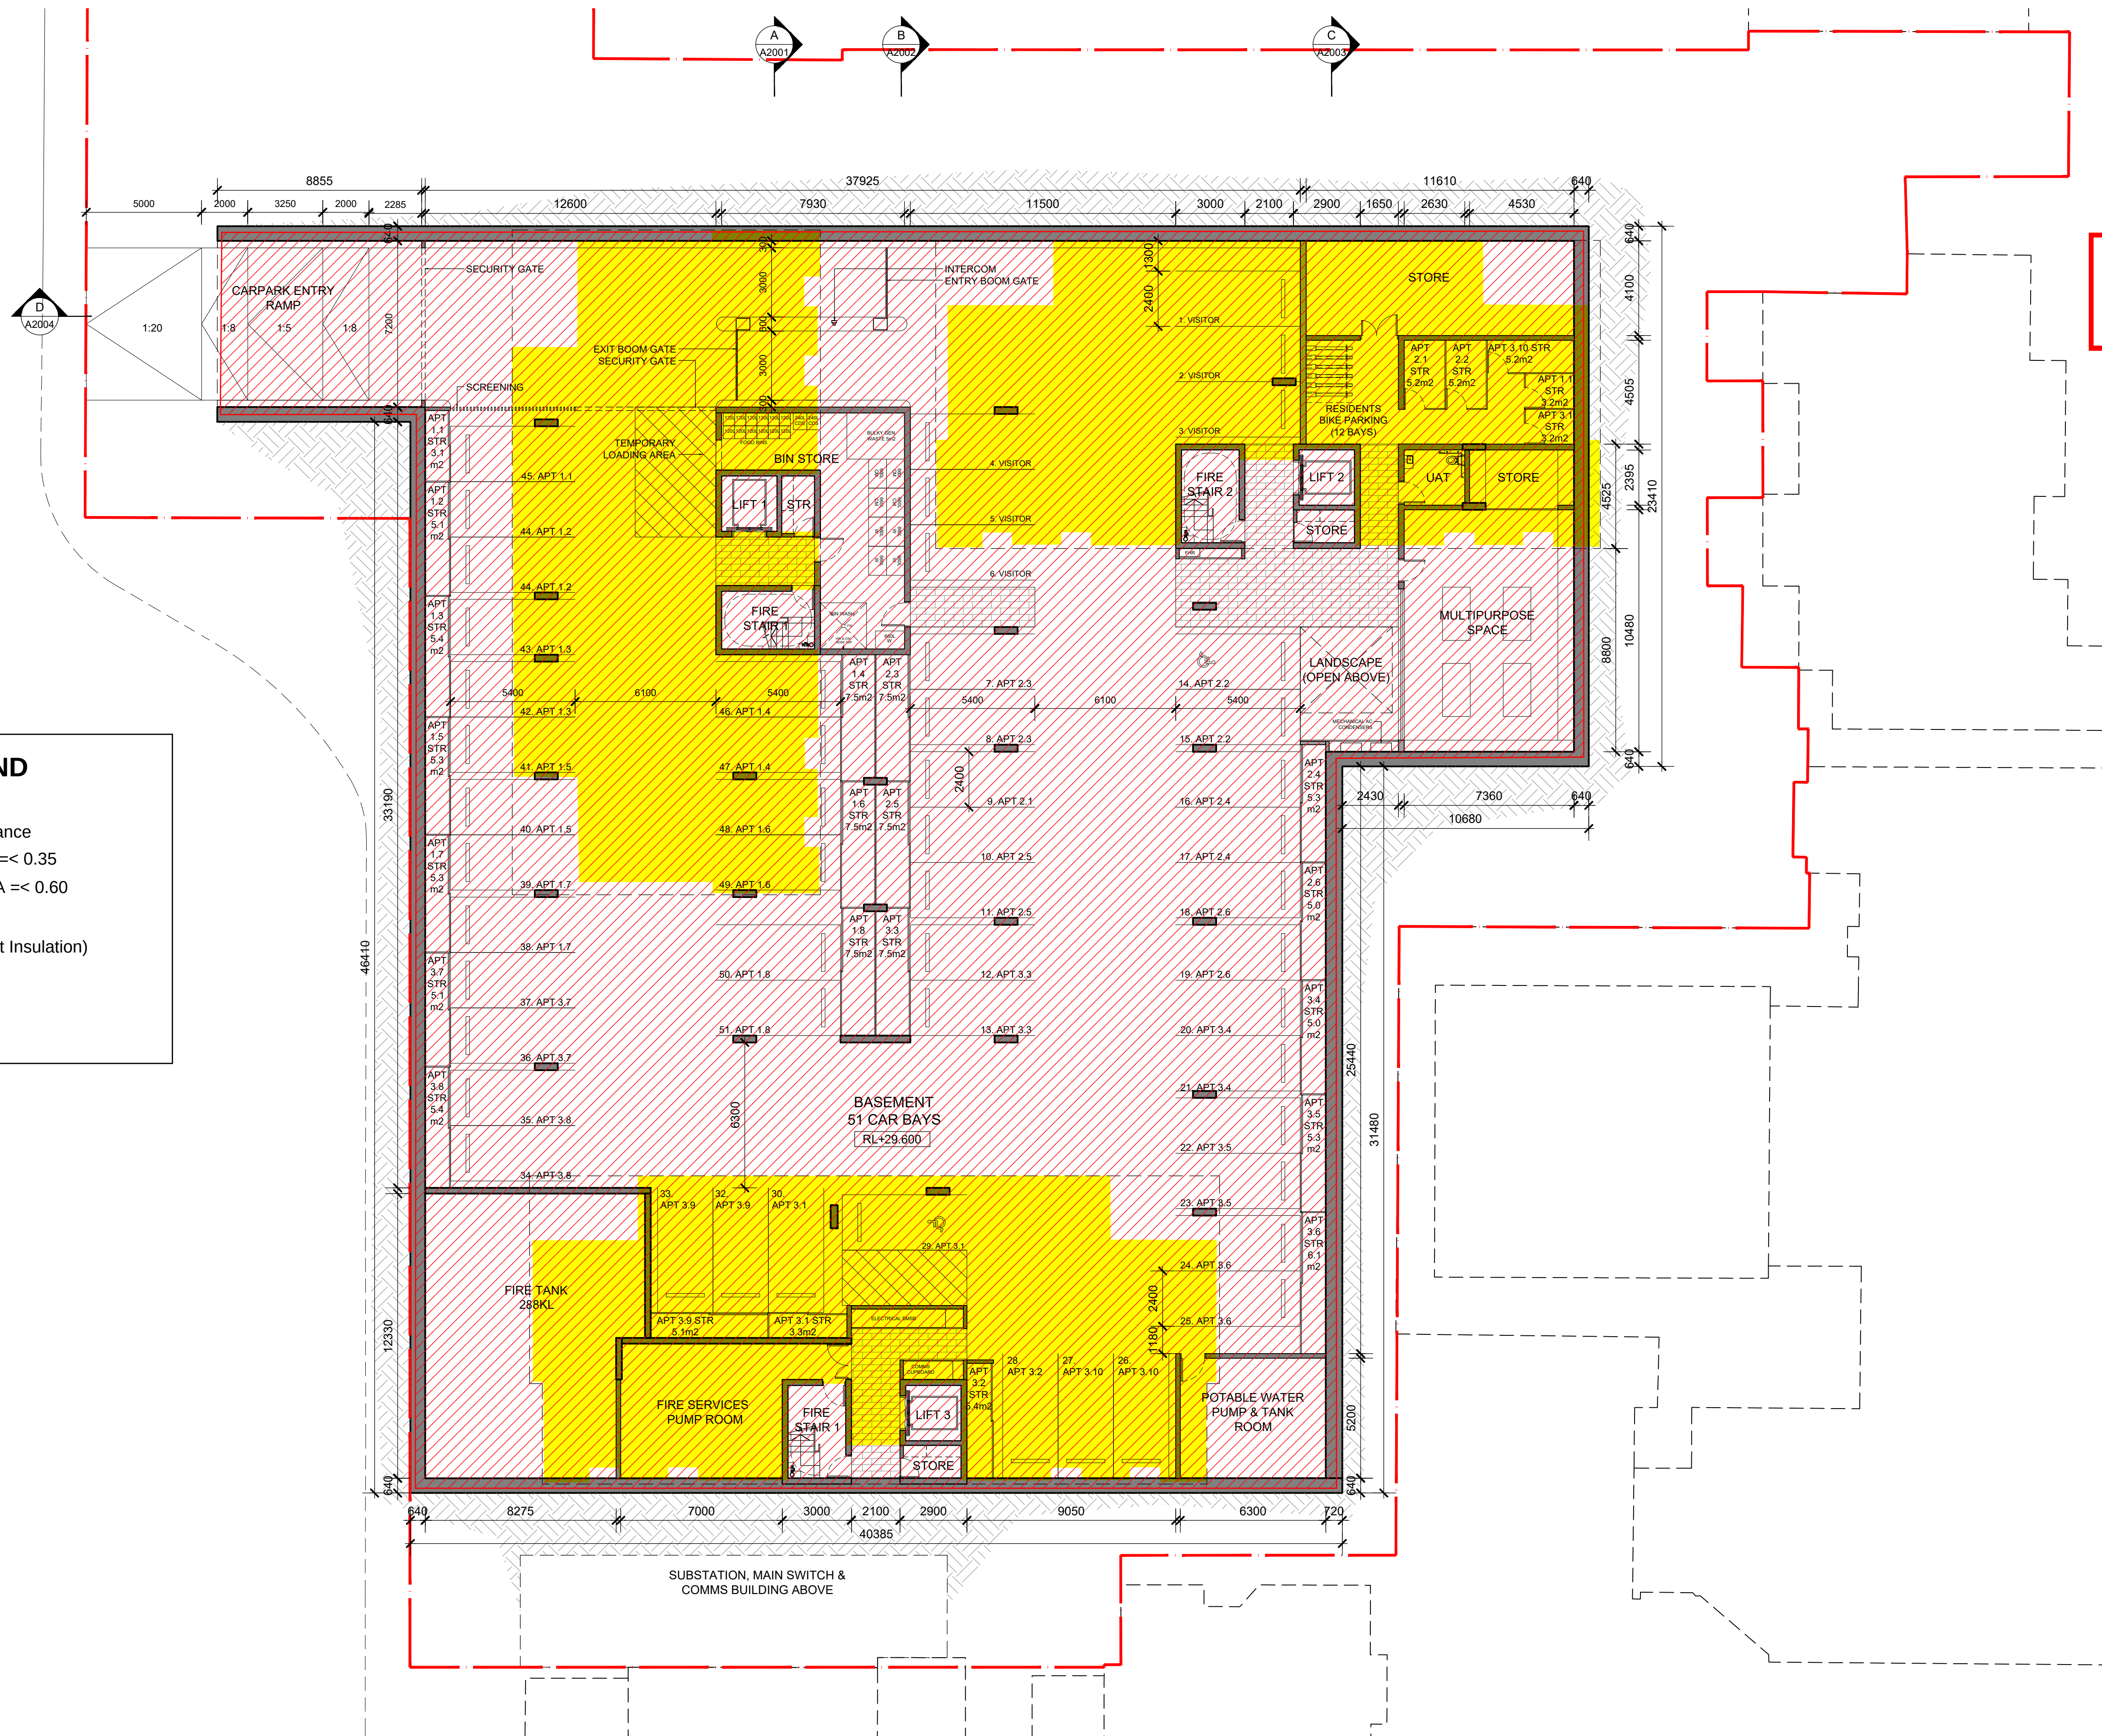

**TOWN OF CLAREMONT
RECEIVED
9/07/2026**

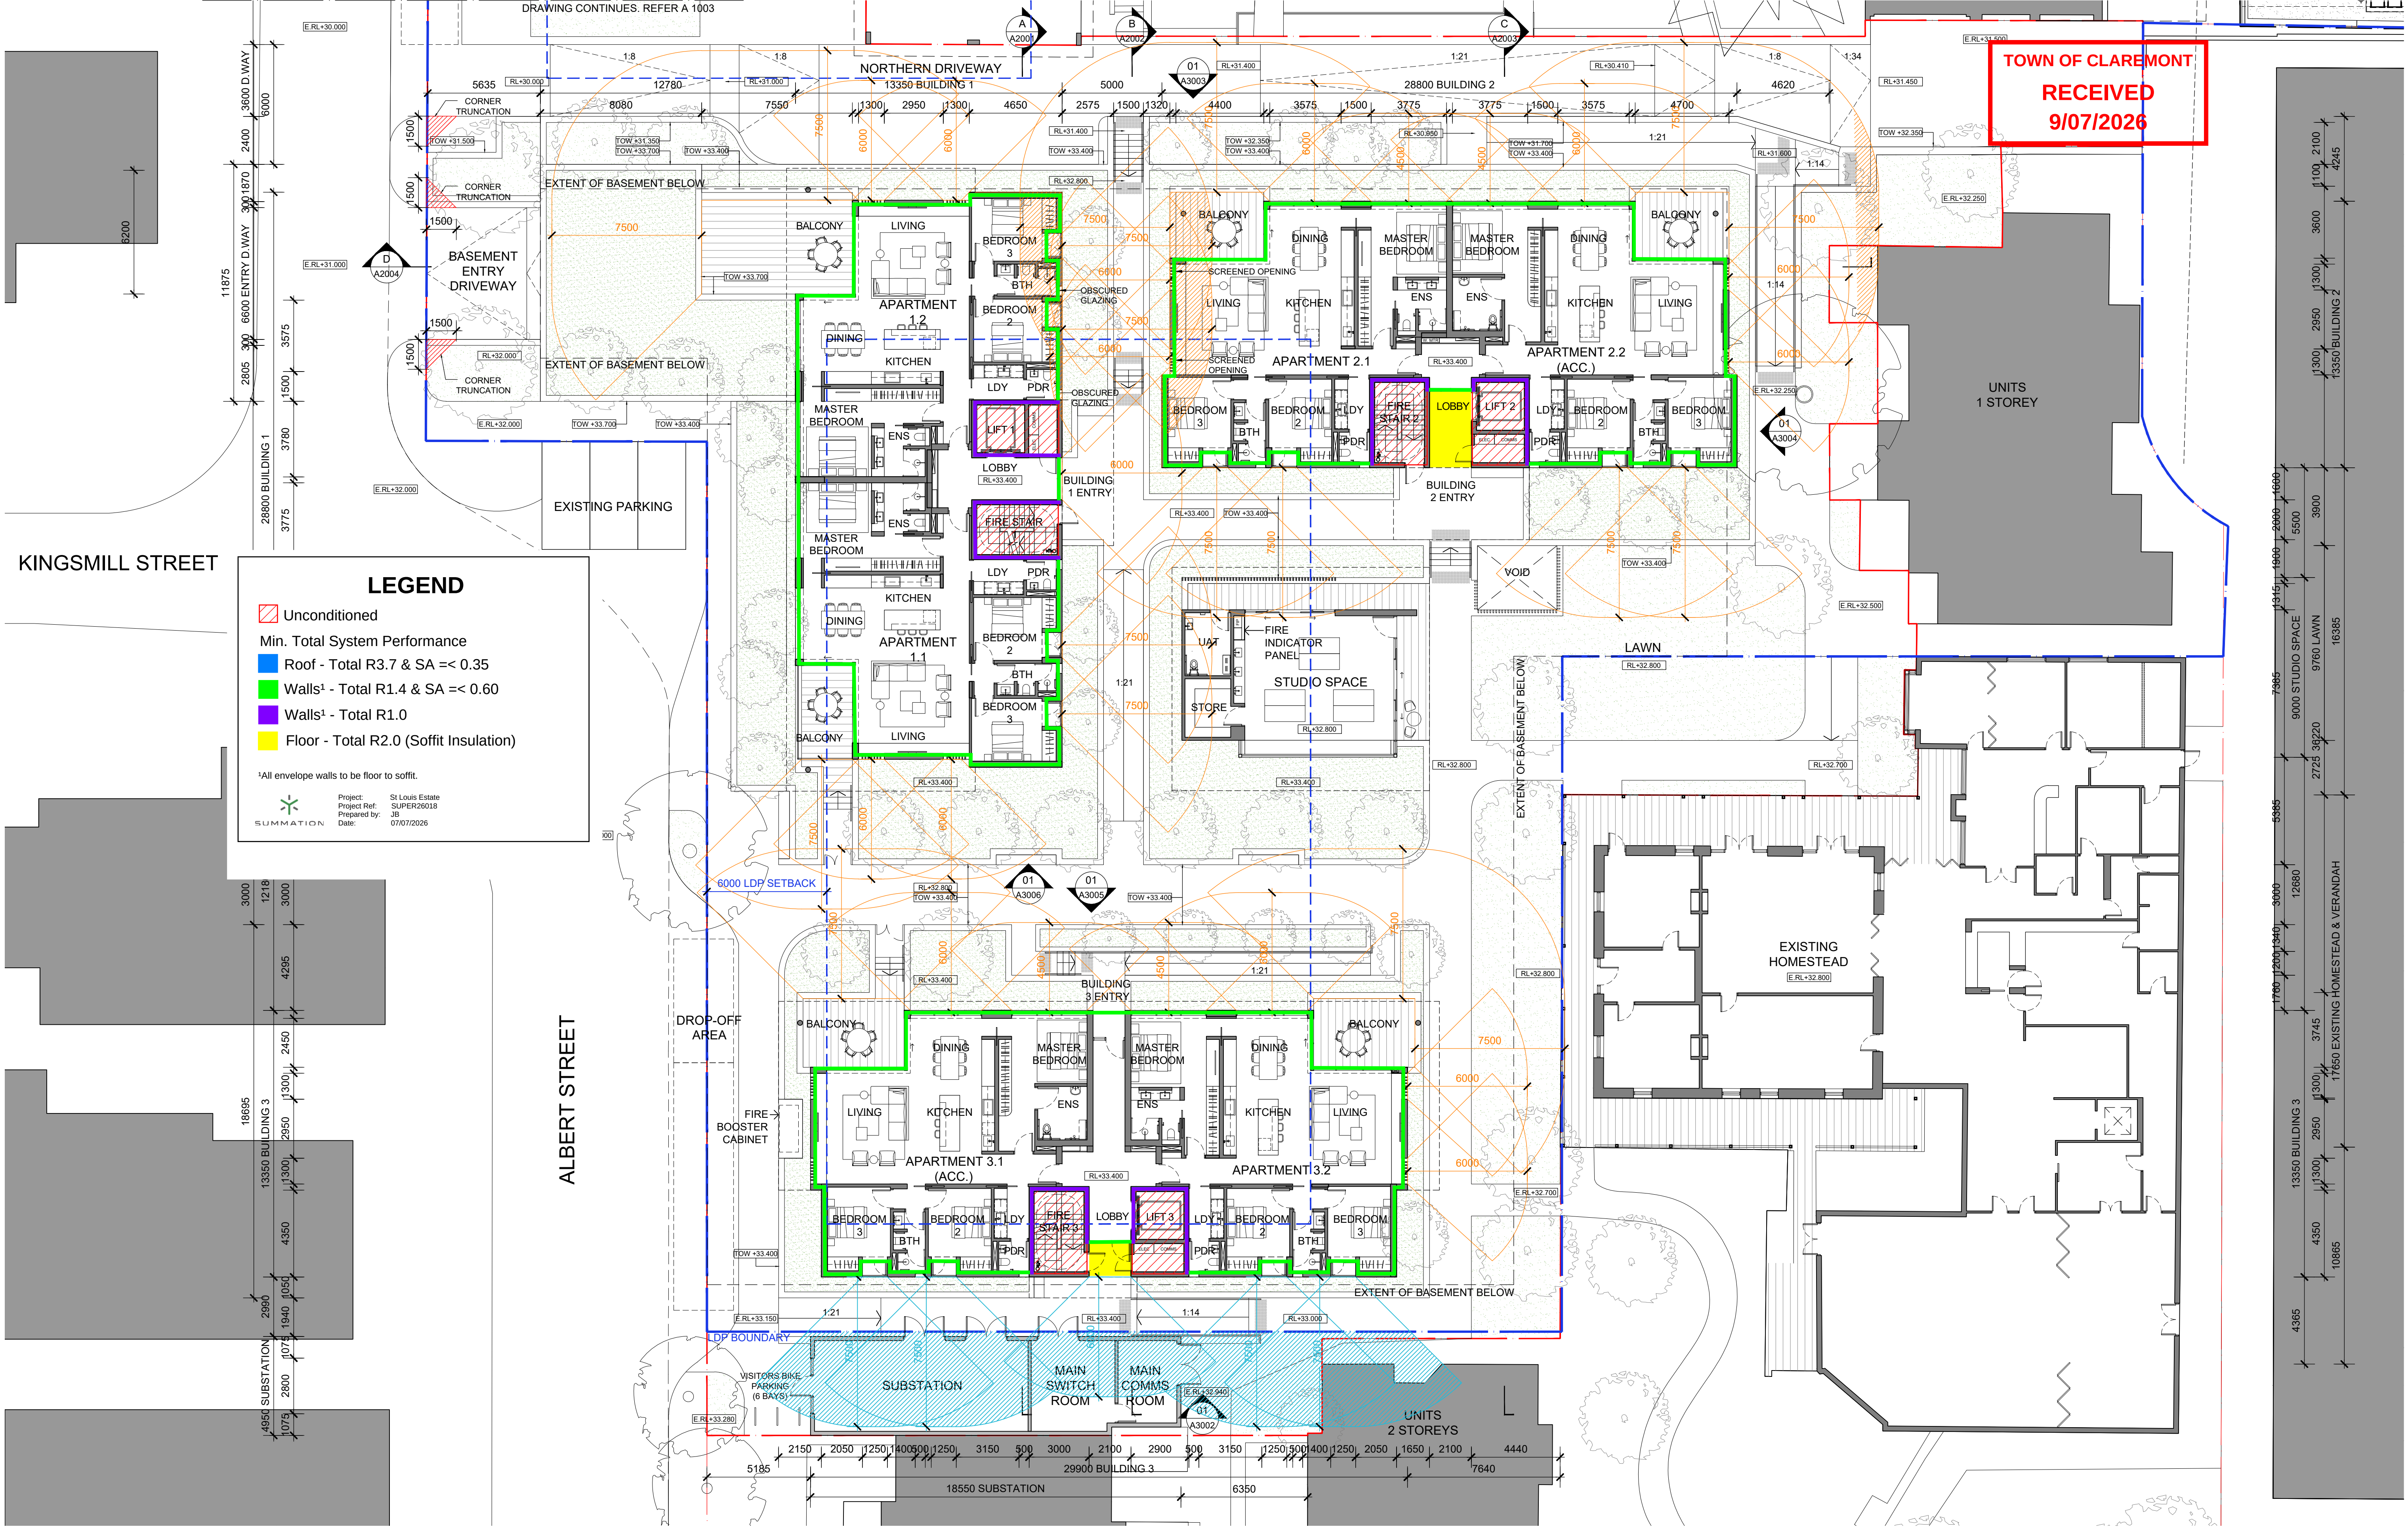

TOWN OF CLAREMONT
RECEIVED
9/07/2026

KINGSMILL STREET

ALBERT STREET

LEGEND

- Unconditioned
- Min. Total System Performance
- Roof - Total R3.7 & SA <= 0.35
- Walls¹ - Total R1.4 & SA <= 0.60
- Walls¹ - Total R1.0
- Floor - Total R2.0 (Soffit Insulation)

¹All envelope walls to be floor to soffit.

Project: St Louis Estate
Project Ref: SUPER26018
Prepared by: JB
Date: 07/07/2026

KHA

- LEGEND
- LDP BOUNDARY
- PROJECT BOUNDARY
- CONE OF VISION - INSIDE LDP BOUNDARY
- CONE OF VISION - OUTSIDE LDP BOUNDARY

Rev. Date: A 29.06.26
Amendment: DA SUBMISSION

Kerry Hill Architects Pty Ltd.
30 Mount Street, Fremantle
Western Australia
T +61 (8) 9336 4545

Disclaimer
1. Do not scale drawings. Written dimensions govern.
2. All Dimensions are in millimeters unless otherwise noted.
3. All Dimensions are to be verified on site prior to proceeding with the work.
4. Kerry Hill Architects are to be notified in writing of any discrepancies.
5. This drawing must be read in conjunction with all relevant contracts, reports specification and drawings.
6. This document has been prepared by Kerry Hill Architects Pty Ltd (KHA) for the purpose of conveying design intent. This document does not represent a complete design and is for the purpose of conveying design intent. All recipients of this document should make their own enquiries to verify the content themselves and with all other relevant disciplines. This document does not form part of any construction contract and should not be relied upon for the purpose of construction.

Project: SLE - ALBERT STREET

Client: ST LOUIS ESTATE

Project No. 660


Drawing Status: DA SUBMISSION

Drawing: GROUND FLOOR
GENERAL ARRANGEMENT PLAN

Scale at A1/A3: 1:150 / 1:300
Drawing No. A 1002

Date: 29.06.26

Revision: A

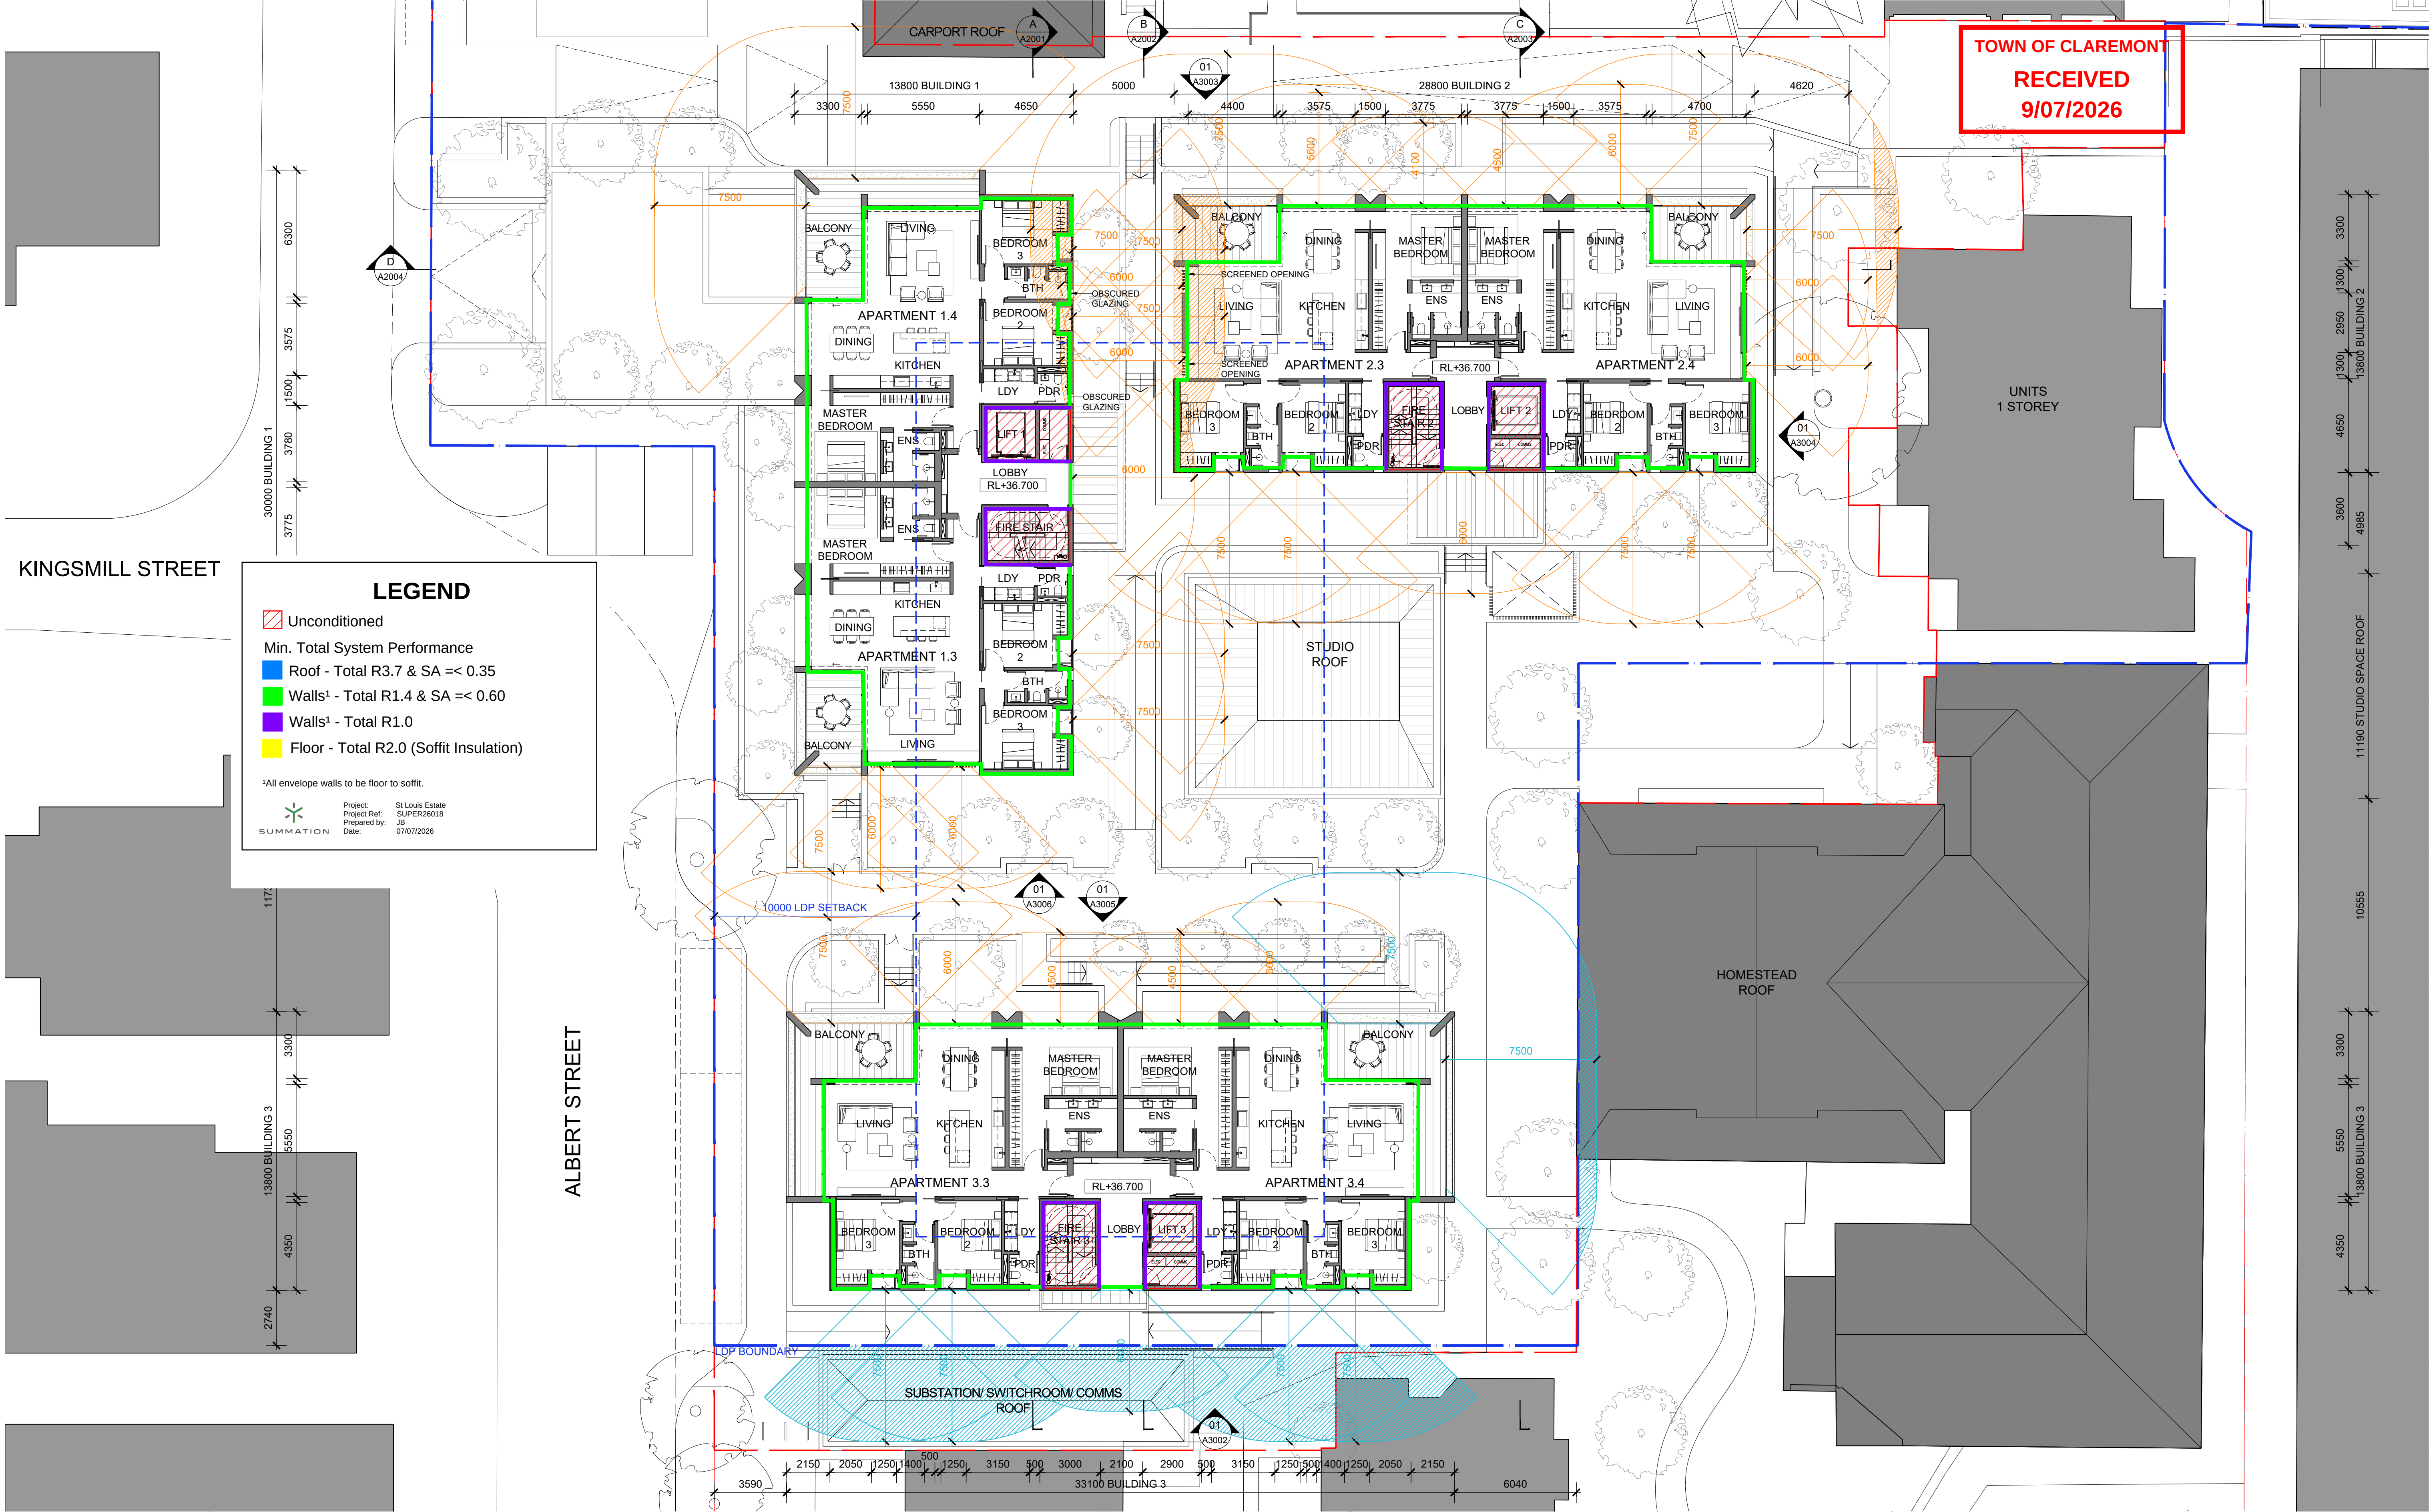

KINGSMILL STREET

ALBERT STREET

TOWN OF CLAREMONT
RECEIVED
9/07/2026

Unconditioned

Min. Total System Performance

Roof - Total R3.7 & SA <= 0.35

Walls¹ - Total R1.4 & SA <= 0.60

Walls¹ - Total R1.0

Floor - Total R2.0 (Soffit Insulation)

Project: St Louis Estate
Project Ref: SUPER26018
Prepared by: JB
Date: 07/07/2026

1All envelope walls to be floor to soffit.

KHA

- LEGEND**
- LDP BOUNDARY
 - PROJECT BOUNDARY
 - CONE OF VISION - INSIDE LDP BOUNDARY
 - CONE OF VISION - OUTSIDE LDP BOUNDARY

Rev. Date Amendment
A 29.06.26 DA SUBMISSION

Kerry Hill Architects Pty Ltd.
30 Mount Street, Fremantle
Western Australia
T +61 (8) 9336 4545

Disclaimer
1. Do not scale drawings. Written dimensions govern.
2. All Dimensions are in millimeters unless otherwise noted.
3. All Dimensions are to be verified on site prior to proceeding with the work.
4. Kerry Hill Architects are to be notified in writing of any discrepancies.
5. This drawing must be read in conjunction with all relevant contracts, reports specification and drawings.
6. This document has been prepared by Kerry Hill Architects Pty Ltd (KHA) for the purpose of conveying design intent. This document does not represent a complete design and is for the purpose of conveying design intent. It does not accept liability for loss or damage incurred as a result of the use, or reliance on the accuracy, of this information. All recipients of this document should make their own enquiries to verify the content themselves and with all other relevant disciplines. This document does not form part of any construction contract and should not be relied upon for the purpose of construction.

Project
SLE - ALBERT STREET

Client
ST LOUIS ESTATE

Project No.
660


Drawing Status
DA SUBMISSION


Drawing
LEVEL 02
GENERAL ARRANGEMENT PLAN

Scale at A1/A3
1:150 / 1:300 Drawing No.
A 1005

Date
29.06.26

Revision
A

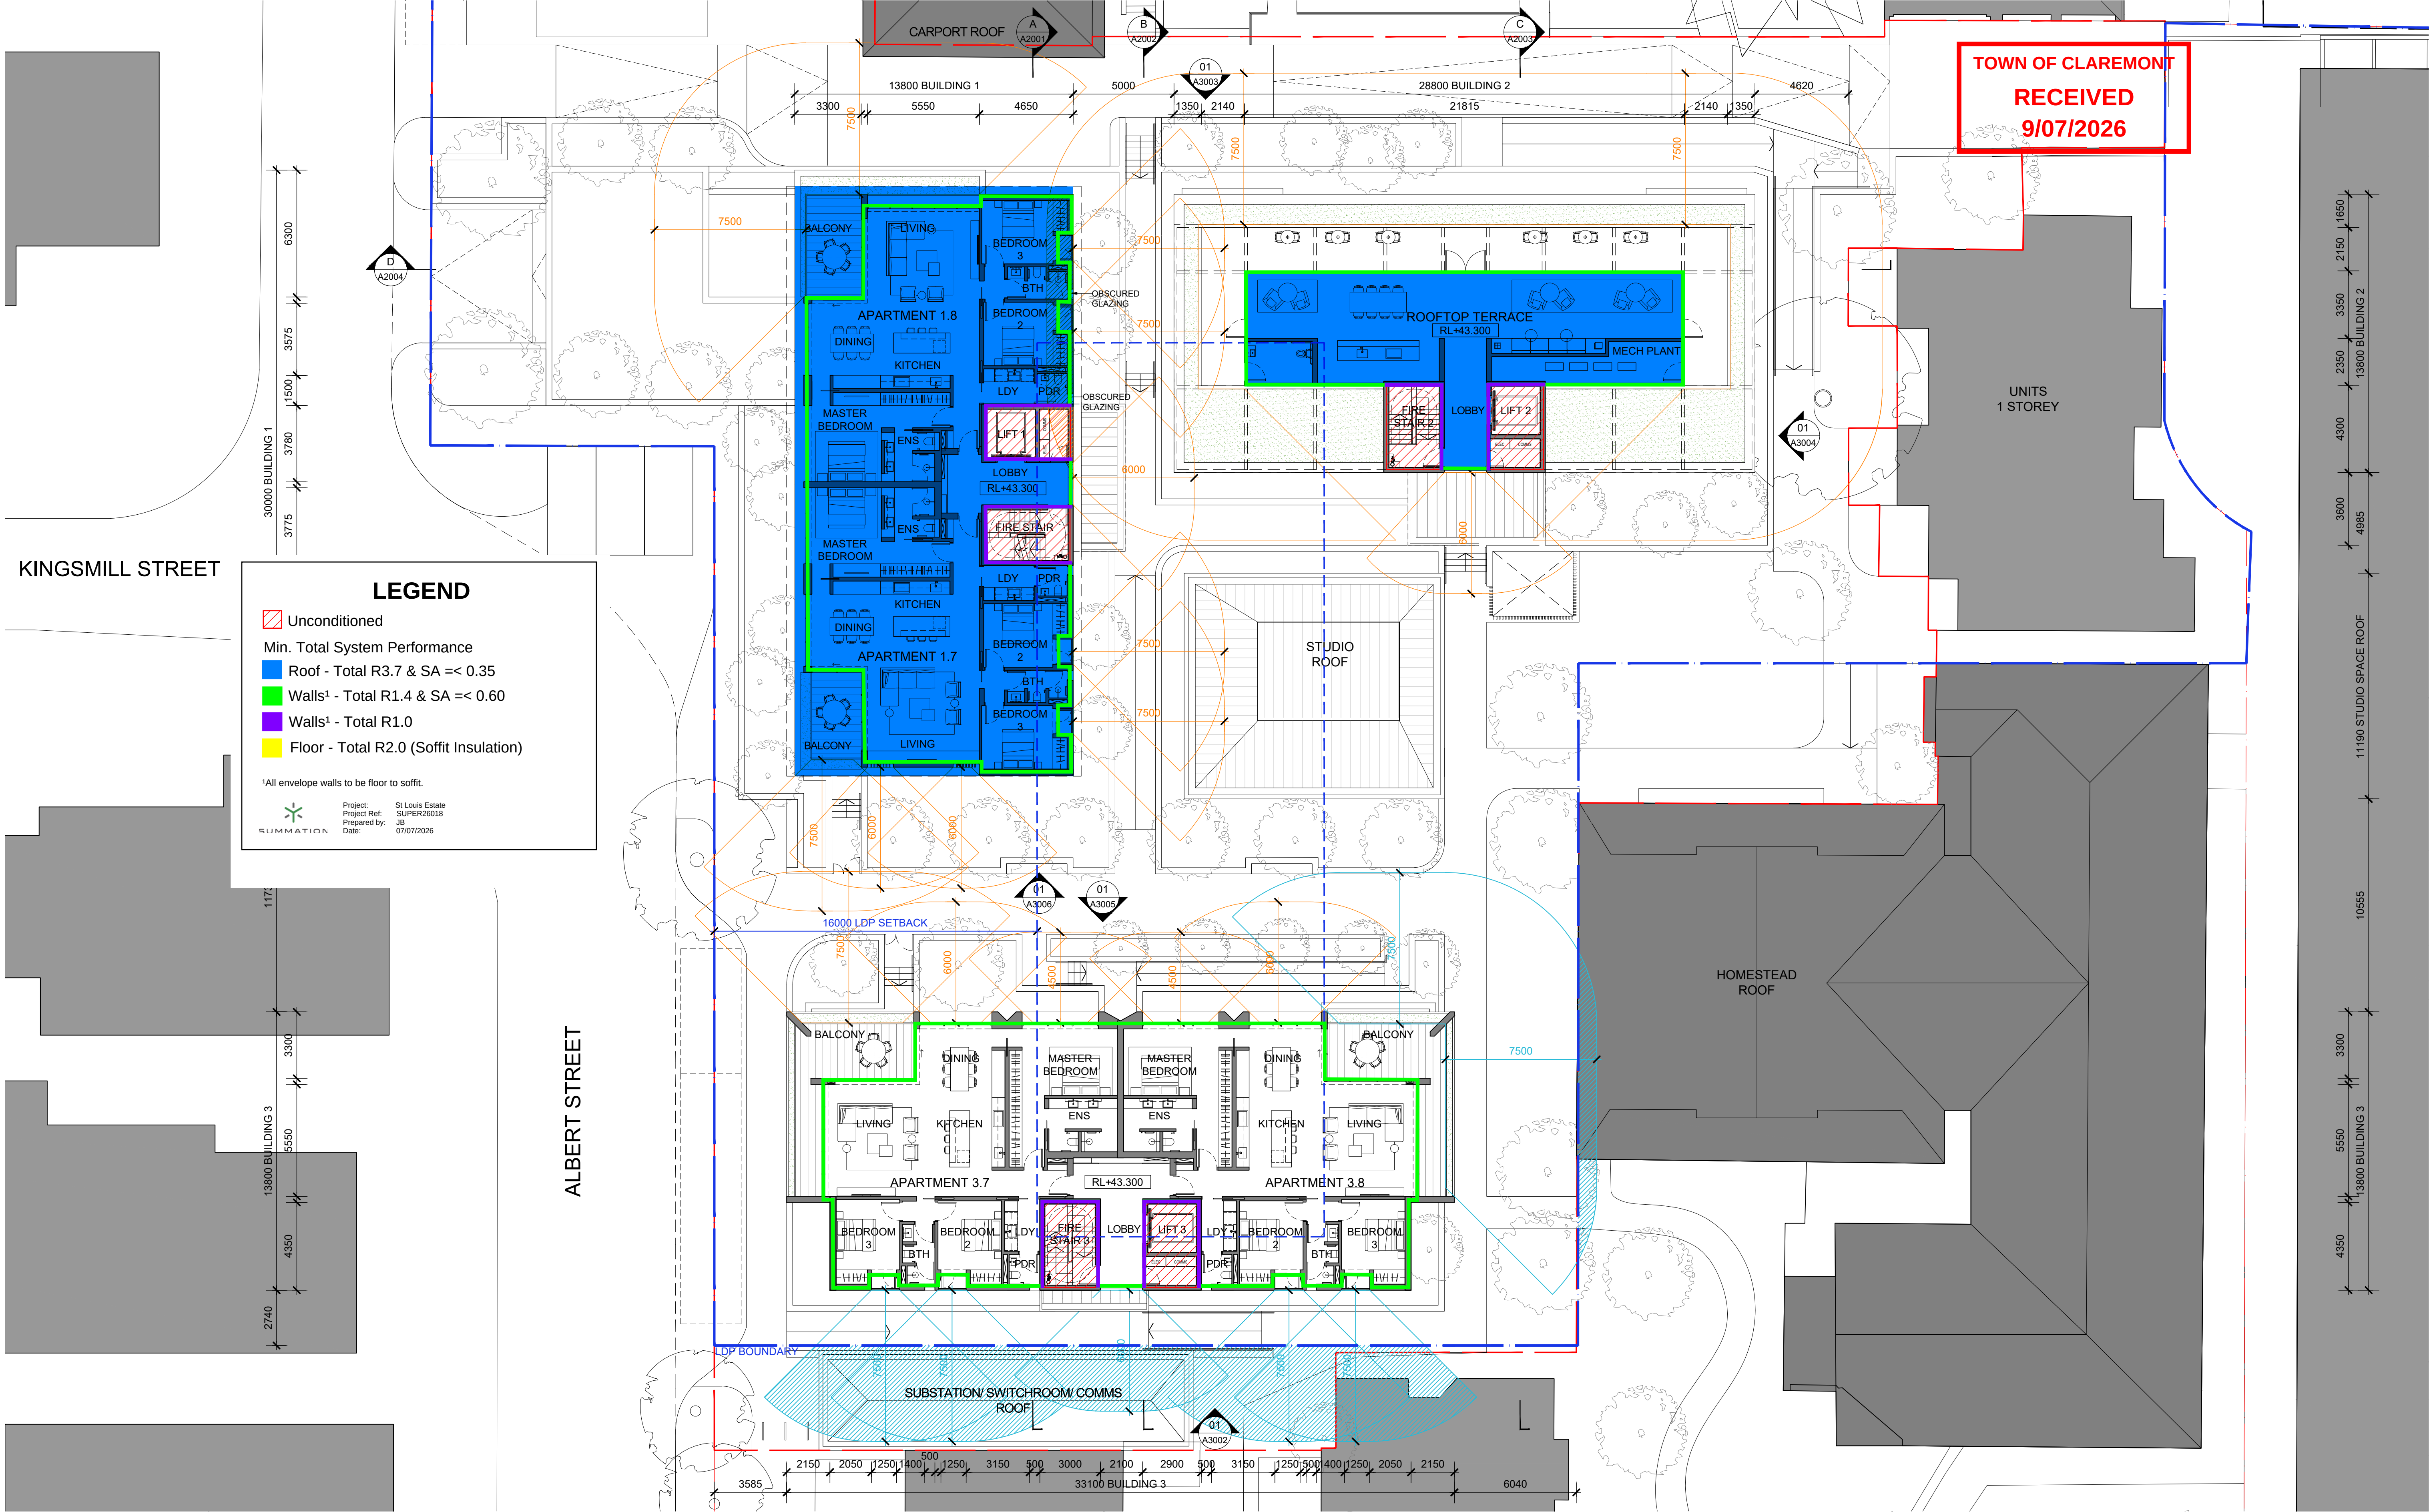

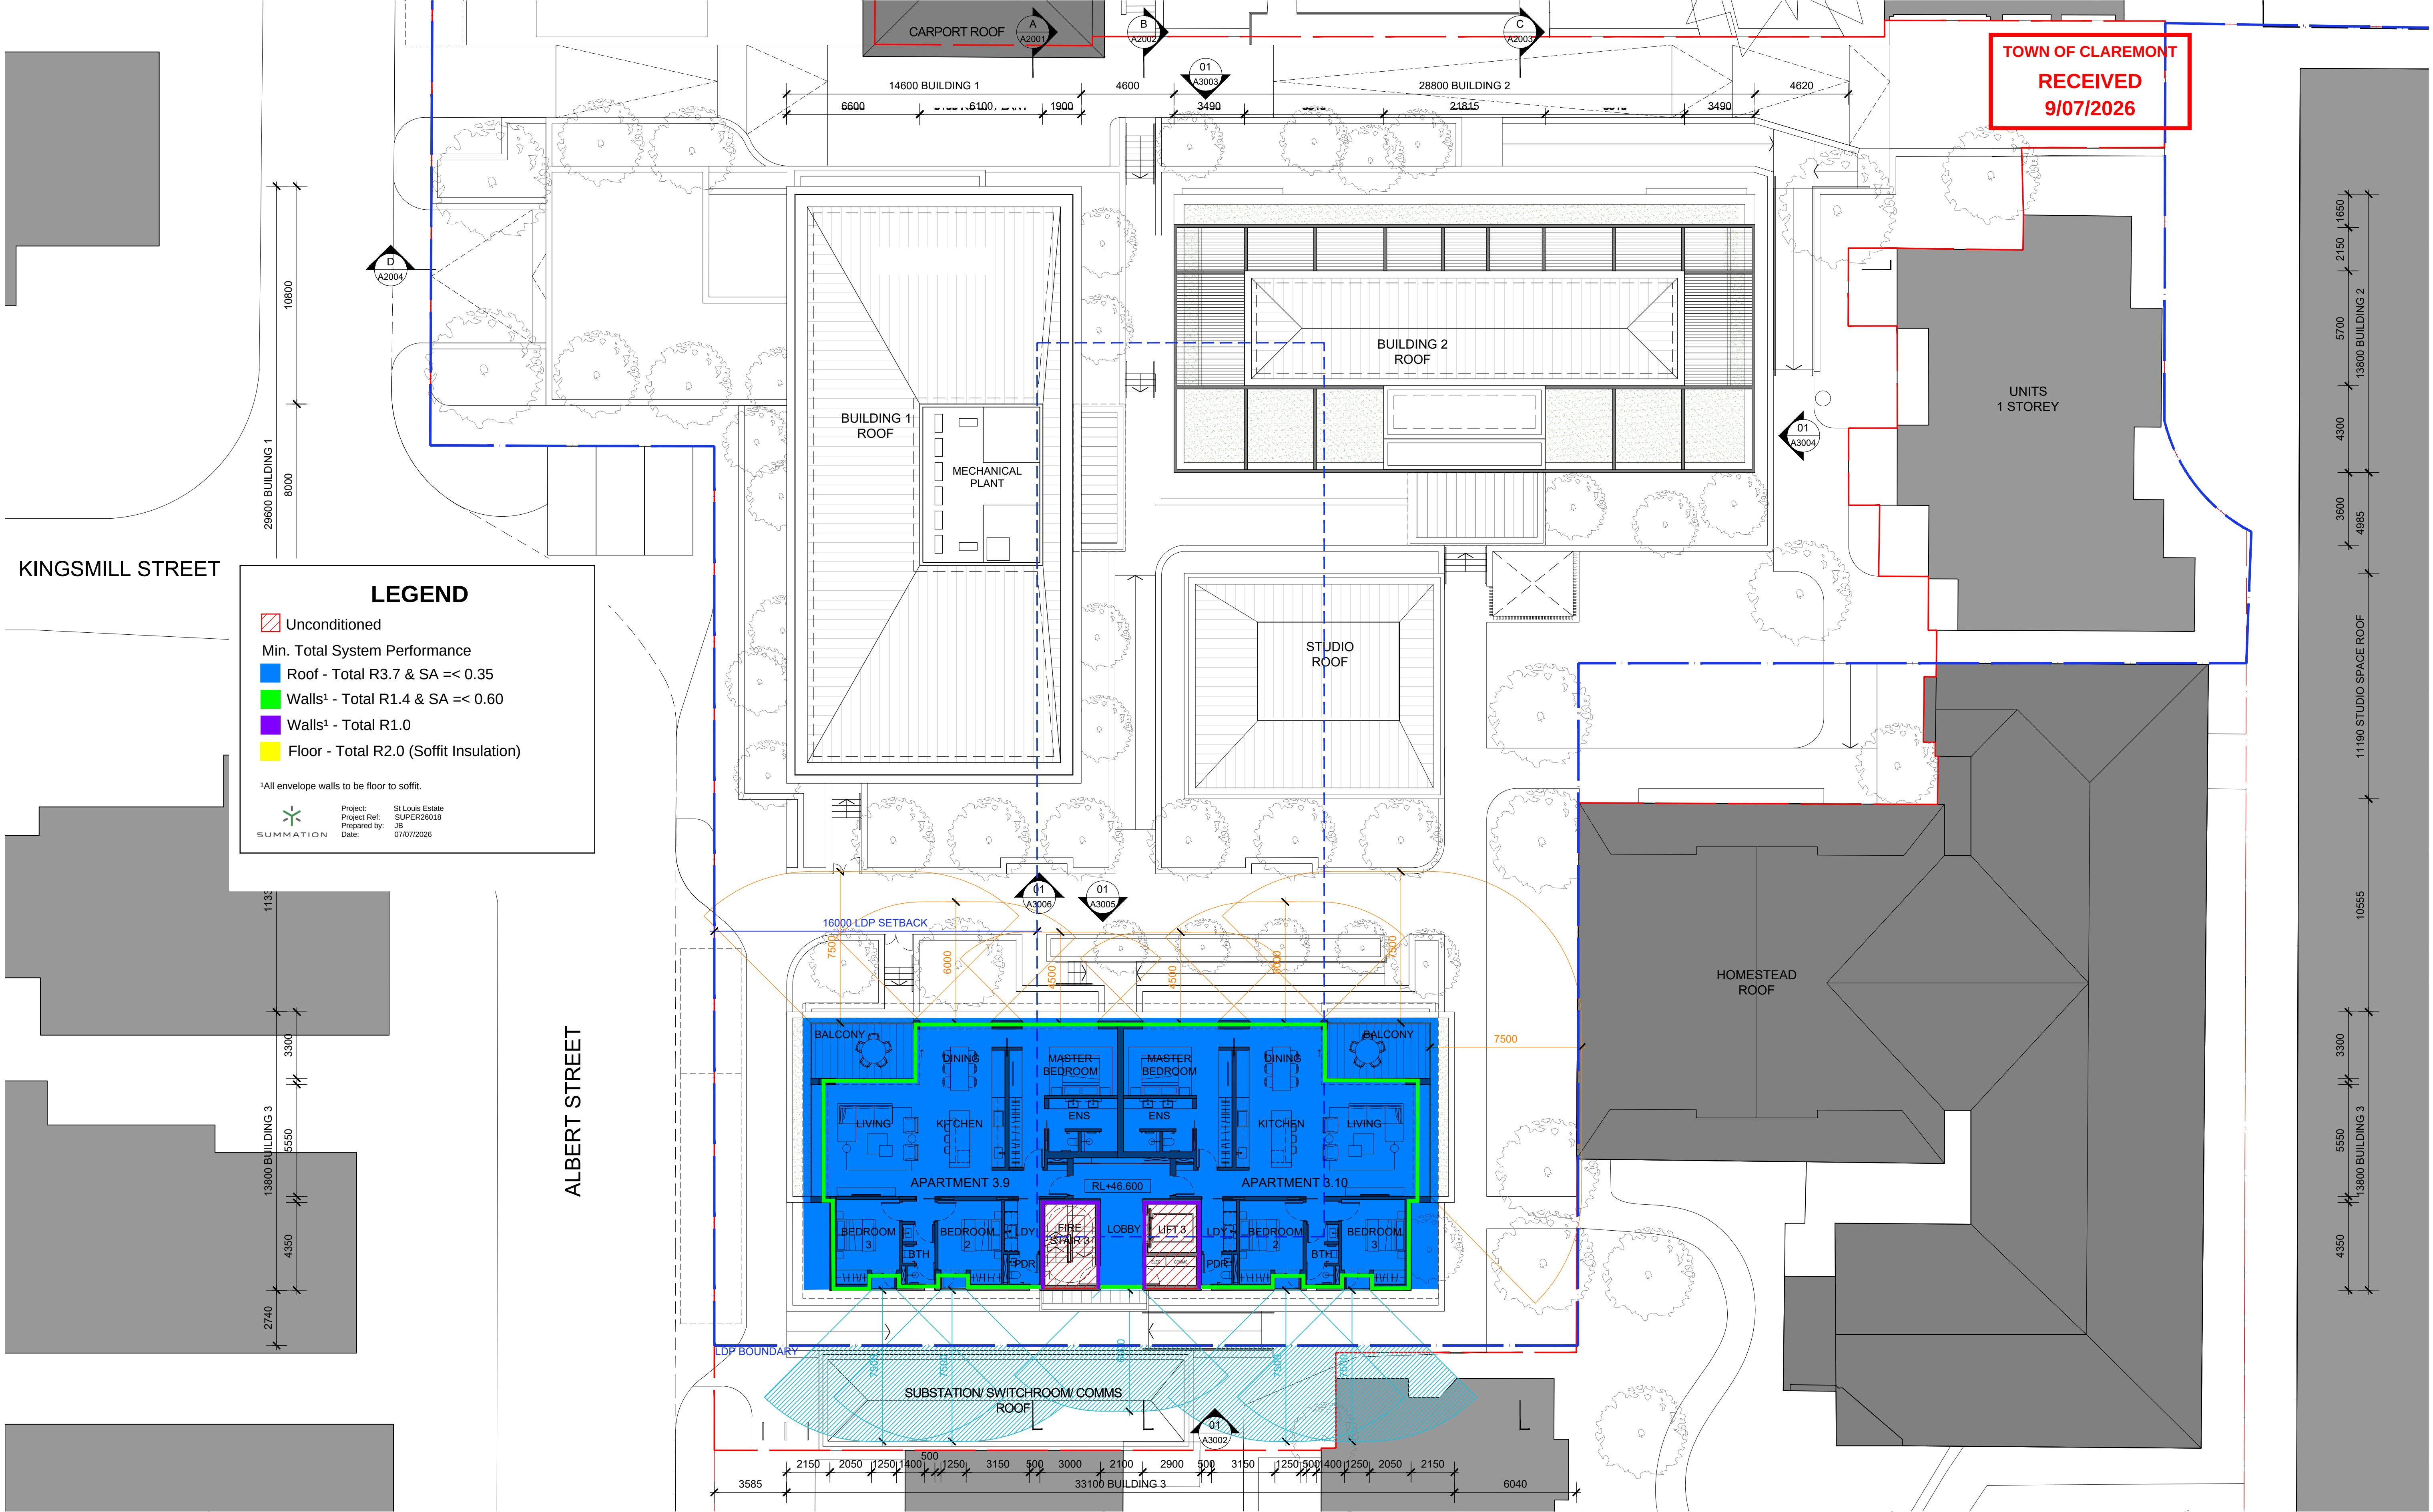



St. Louis Estate | ESD Section J Preliminary Advise
Project Ref: SUPER26018
Date: 07/07/26

TOWN OF CLAREMONT
RECEIVED
9/07/2026

Appendix C Better Building Façade Calculation Report



NCC 2025: The Facade Calculator Report

Dashboard export · NCC 2025 Specification 37. Generated 6/10/2026, 3:50:09 PM.

Overall compliance

COMPLIES

Wall-glazing U-value

1.56 PASS

Limit: 1.60 W/m²·K (CZ5 / ward)

Method 1 (per-aspect)

2 / 4 FAIL

aspects satisfy $SA \leq SA_{limit}$ individually

Method 2 (energy ratio)


0.0854 PASS

Reference: 0.0881


Visual summary

TOWN OF CLAREMONT
RECEIVED
9/07/2026

SA by orientation

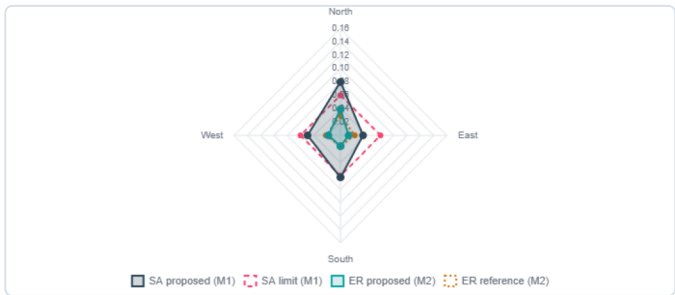

Compliance budget used

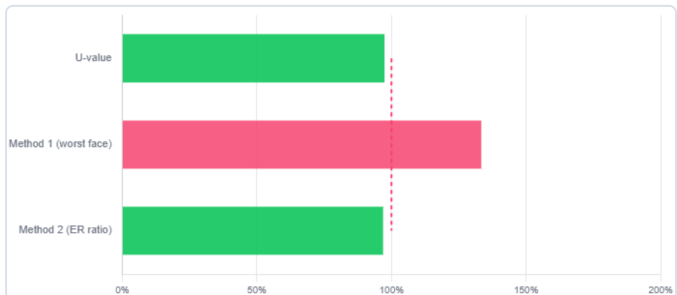

Per-aspect breakdown

Aspect	Share	WWR	P/H	D/W	W/H	S _h	S _v	S	SA	SA limit	M1	ω	ER _p	ER _r
North	26.1%	58.3%	0.57	0.00	0.00	0.528	1.000	0.528	0.080	0.06	FAIL	1.88	0.0392	0.0294
North-East	— excluded													
East	23.9%	26.2%	0.63	0.00	0.00	0.495	1.000	0.495	0.034	0.06	PASS	1.48	0.0119	0.0213
South-East	— excluded													
South	26.1%	29.1%	0.29	0.00	0.00	0.825	1.000	0.825	0.062	0.06	FAIL	1.00	0.0162	0.0156
South-West	— excluded													
West	23.9%	40.0%	0.67	0.00	0.00	0.475	1.000	0.475	0.049	0.06	PASS	1.52	0.0180	0.0218
North-West	— excluded													

Compliance checks

U-value:

$U_{sys} \leq UV_{limit}$

$1.5581 \leq 1.60 \rightarrow \text{PASS } \checkmark$

TOWN OF CLAREMONT

RECEIVED

9/07/2026

Solar Admittance – Method 1 (per-aspect):

North SA = 0.0800 > 0.0600 → FAIL ✗

East SA = 0.0337 ≤ 0.0600 → PASS ✓

South SA = 0.0623 > 0.0600 → FAIL ✗

West SA = 0.0494 ≤ 0.0600 → PASS ✓

Method 1 overall → FAIL ✗ (2 of 4 aspects pass)

Solar Admittance – Method 2 (energy ratio):

$ER_{proposed} \leq ER_{reference}$

$0.0854 \leq 0.0881 \rightarrow \text{PASS } \checkmark$

Solar-Admittance leg passes if EITHER method passes:

Method 1 ✗ OR Method 2 ✓ → PASS ✓

Overall (U-value AND SA leg): COMPLIES ✓